

W1

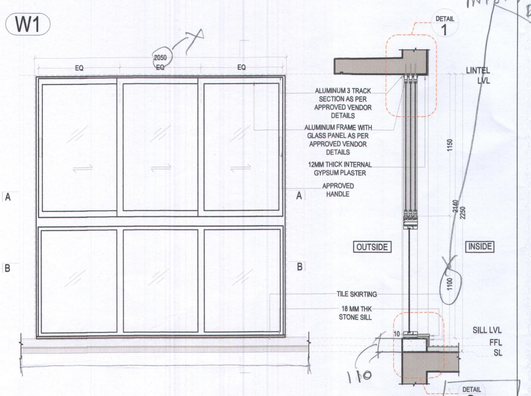


ELEVATION AA
(ELEVATION FROM INSIDE)

SECTION CC

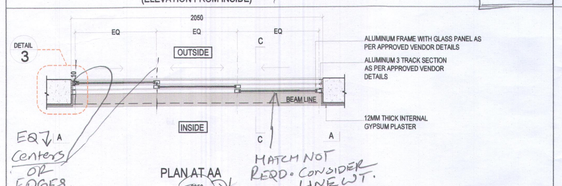


PLAN AT AA

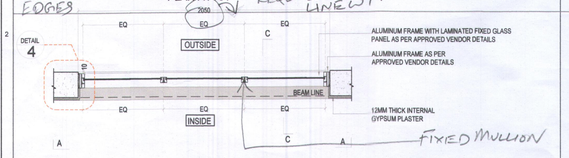

PLAN AT BB


TYPE	W1-THREE SHUTTER SLIDING WINDOW
STRUCTURAL SIZE OPENING	2050 X 2140
SILL HEIGHT (FROM SFL)	110
LINTEL HEIGHT (FROM SFL)	2250
DESCRIPTION	POWDER COATED ALUMINUM SLIDING WINDOW WITH CLEAR GLASS AS PER APPROVED VENDOR DETAILS
LOCATION	LIVING ROOM

W2 W3 W3A W7

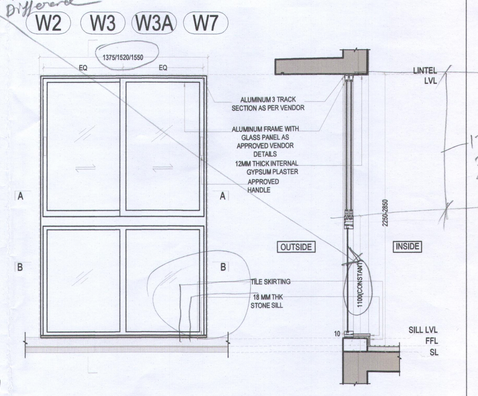


ELEVATION AA
(ELEVATION FROM INSIDE)

SECTION CC

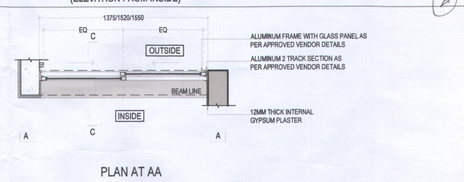


PLAN AT AA

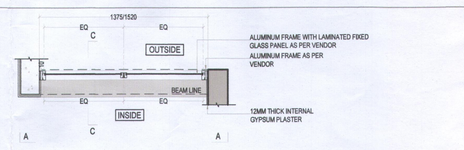

PLAN AT BB


TYPE	W2, W3, W3A & W7 -TWO SHUTTER SLIDING WINDOW WITH FIXED PANEL(LOWER)
STRUCTURAL SIZE OPENING	1365/1520/1550 X 2140-2740
SILL HEIGHT (FROM SFL)	110
LINTEL HEIGHT (FROM SFL)	2250-2740
DESCRIPTION	POWDER COATED ALUMINUM SLIDING WINDOW WITH CLEAR GLASS AS PER APPROVED VENDOR DETAILS
LOCATION	MASTER BEDROOM, BEDROOM, BEDROOM - 02, FLOOR LOBBY

W4 W4A

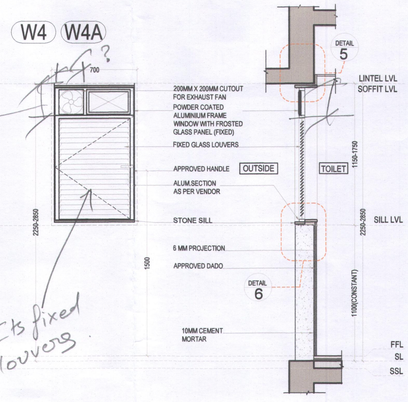

ELEVATION AA
(ELEVATION FROM TOILET)


SECTION CC

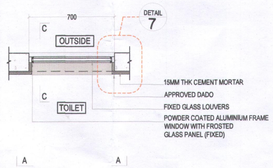

PLAN


TYPE	W4 & W4A-LOUVERED WINDOW WITH EXHAUST
STRUCTURAL SIZE OPENING	700 X 1150-1750
SILL HEIGHT (FROM SFL)	1100(CONSTANT)
LINTEL HEIGHT (FROM SFL)	2250-2850
DESCRIPTION	ANODISED ALUMINIUM FRAME PARTLY FIXED AND PARTLY LOUVERED WINDOW WITH EXHAUST FAN & ANODISED ALUMINIUM LOUVERS OF APPROVED MAKE & COLOUR PROVIDED WITH LOCKING SYSTEM & HANDLES
LOCATION	TOILET (FLOREA A & D)

W5 W5A

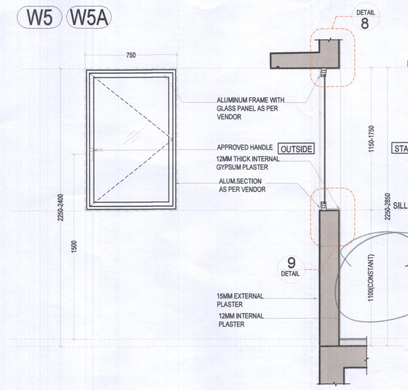

ELEVATION AA
(ELEVATION FROM TOILET)

SECTION CC

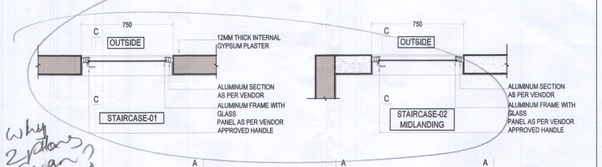


PLAN (STAIRCASE-01)

PLAN (STAIRCASE-02)


TYPE	W5 & W5A - SIDE HUNG OPENABLE WINDOW		
STRUCTURAL SIZE OPENING	750 X 1150-1750		
SILL HEIGHT (FROM SFL)	1100(CONSTANT)		
LINTEL HEIGHT (FROM SFL)	2250-2850		
DESCRIPTION	POWDER COATED ALUMINUM SIDE HUNG OPENABLE WINDOW WITH CLEAR GLASS AS PER APPROVED VENDOR DETAILS.		
LOCATION	ALL STAIRCASE (FLOREA A & D)		

W6 W6A

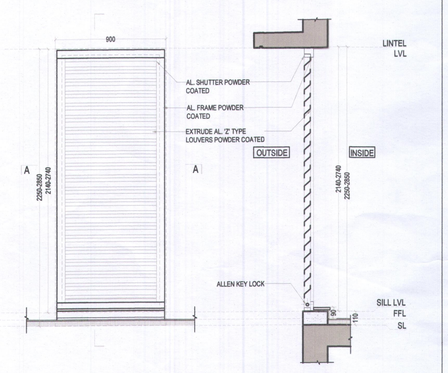

ELEVATION AA
(ELEVATION FROM LOBBY)


SECTION CC

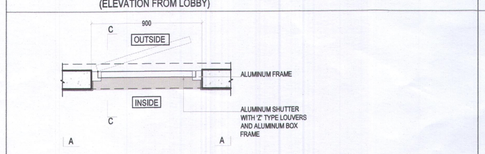

PLAN AT AA


TYPE	W6 & W6A -OPENABLE LOUVERED WINDOW
STRUCTURAL SIZE OPENING	900 X 2140-2740
SILL HEIGHT (FROM SFL)	110
LINTEL HEIGHT (FROM SFL)	2250-2850
DESCRIPTION	POWDER COATED ALUMINUM WINDOW WITH LOUVERS
LOCATION	FLOOR LOBBY

W7A

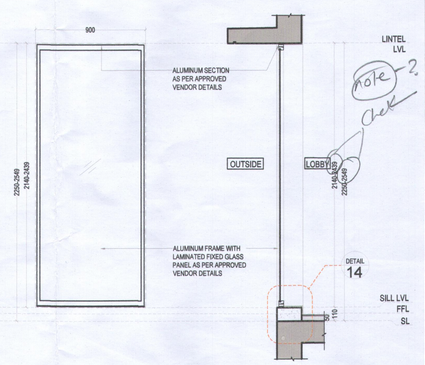

ELEVATION FF
(ELEVATION FROM LOBBY)


SECTION CC

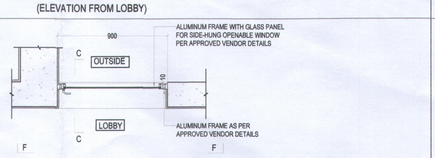

PLAN (W7A)


TYPE	W7A-TWO SHUTTER OPENABLE WINDOW
STRUCTURAL SIZE OPENING	1550 X 2140-2439
SILL HEIGHT (FROM SFL)	110
LINTEL HEIGHT (FROM SFL)	2250-2549
DESCRIPTION	POWDER COATED ALUMINUM SLIDING WINDOW WITH CLEAR GLASS AS PER APPROVED VENDOR DETAILS
LOCATION	FLOOR LOBBY (FLOREA A & D)

W8 W8A

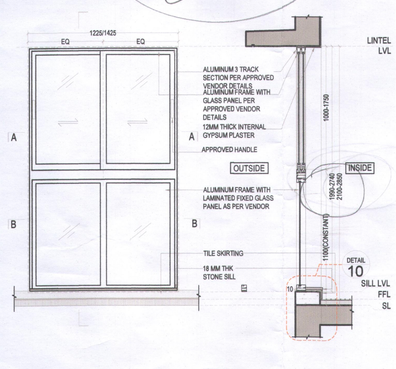


ELEVATION AA
(ELEVATION FROM INSIDE)

SECTION CC

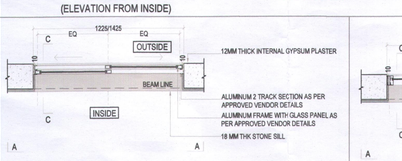


PLAN AT AA

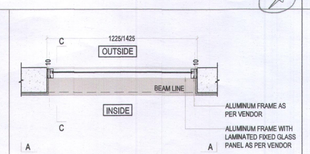

PLAN AT BB


TYPE	W8 & W8A -TWO SHUTTER SLIDING WINDOW
STRUCTURAL SIZE OPENING	1225 X 1990 & 1425 X 1990-2740 ON GROUND FLOOR
SILL HEIGHT (FROM SFL)	110
LINTEL HEIGHT (FROM SFL)	2100-2850
DESCRIPTION	POWDER COATED ALUMINUM SLIDING WINDOW WITH CLEAR GLASS AS PER APPROVED VENDOR DETAILS
LOCATION	STUDY ROOM (2.5 BHK) & STUDIO APARTMENT ON GROUND FLOOR (BEDROOM WINDOW)

SD2 SD2A

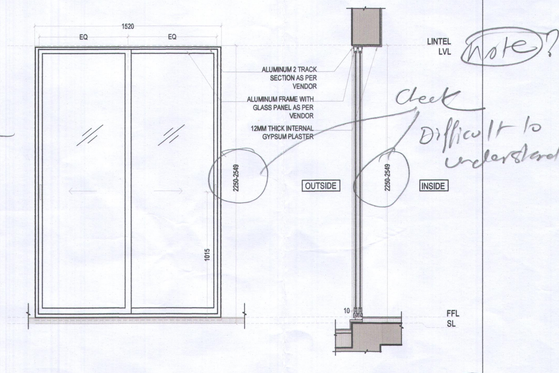

ELEVATION AA
(ELEVATION FROM INSIDE)

SECTION CC

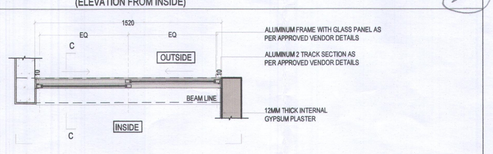

PLAN

TYPE	SD2 & SD2A-TWO SHUTTER SLIDING WINDOW
STRUCTURAL SIZE OPENING	1520 X 2250-2549
SILL HEIGHT (FROM SFL)	0
LINTEL HEIGHT (FROM SFL)	2250-2549
DESCRIPTION	POWDER COATED ALUMINUM SLIDING WINDOW WITH CLEAR GLASS AS PER APPROVED VENDOR DETAILS
LOCATION	MASTER BEDROOM (GARDEN APT.)

GENERAL NOTES

1 : All dimensions are in millimeters and levels in meters unless specified otherwise.
2 : Do not scale the drawing; follow written dimensions.
3 : All dimensions are unfinished dimensions unless specified otherwise.
4 : Any discrepancies should be brought to the notice of the Architect prior to execution of job / procuring materials at site.
5 : This drawing is the property of Kapadia Associates and should not be reproduced, copied, handed over to a third party or used for any purpose other than for which it has been issued.
6 : This drawing is to be read in conjunction with all relevant structural & services drawings.

KEY PLAN

REVISION INDEX

REV.NO.	DATE	DESCRIPTION

CONSULTANTS

STRUCT BOMBAY CONSULTANTS.
Structural Consultants
Tel : 022-24937510,24933986
email : sbcbom@gmail.com

MICRO ENGINEERING
MEP Consultants
Tel : 0120-4558718
email : business@meindia.com

PBB
Planner /Landscape Architect
Tel : 079 6923054
email : landscapeindia@usg.net

STAMP & SIGN	NORTH
	N

PROJECT TITLE	PROJ.NO
PALAVA-LAKEFRONT	L-10518
DRAWING TITLE	DWG.NO
WINDOW DETAILS_FLOREA	702.1
DRAWING STAGE	REV.NO
WORKING DRAWING	R-00

DRAWN	CHECKED	SCALE	DATE
BB/VS	ES	1:25	06-11-2019

KAPADIA ASSOCIATES
architecture • urban design
112-114 Peninsula Centre,Dr. S.S. Rao Road, Off Ambedkar Road,Parel East, Mumbai 400012
Tel : 91-22-6660 2838 / 39
Fax : 91-22-6660 2844
E-mail : kapt@kapt.in
Website: www.kapt.in