

SD1 SD1A

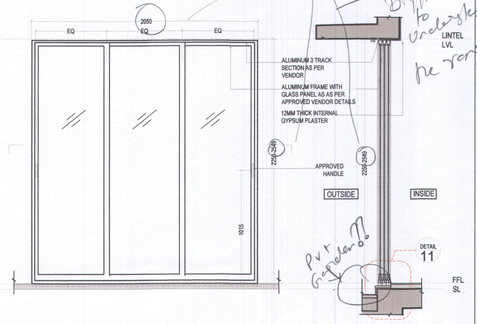

ELEVATION AA
(ELEVATION FROM INSIDE)


SECTION CC

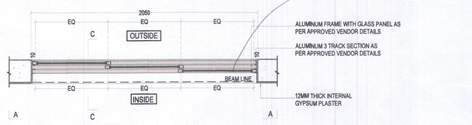


PLAN

TYPE	SD1 & SD1A-THREE SHUTTER SLIDING WINDOW
STRUCTURAL SIZE OPENING	2050 X 2250-2549
SILL HEIGHT (FROM SFL)	0
LINTEL HEIGHT (FROM SFL)	2250-2549
DESCRIPTION	POWDER COATED ALUMINUM SLIDING WINDOW WITH CLEAR GLASS AS PER APPROVED VENDOR DETAILS
LOCATION	LIVING ROOM (DECK & GARDEN APT.)


W1B

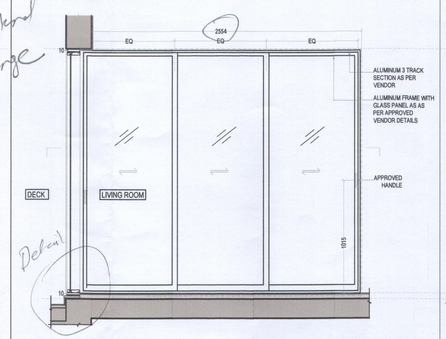

SECTION AA

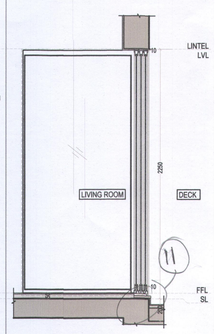


SECTION BB

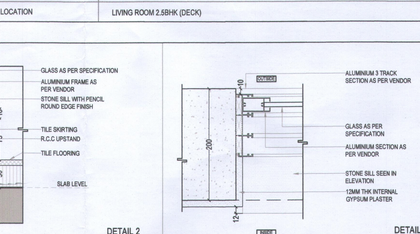


PLAN

TYPE	W1B
STRUCTURAL SIZE OPENING	SLIDING OPENABLE - 2554 X 2250 HT, FIXED GLASS - 1016 X 2250 HT
SILL HEIGHT (FROM SFL)	0
LINTEL HEIGHT (FROM SFL)	2250
DESCRIPTION	POWDER COATED ALUMINUM SLIDING WINDOW WITH CLEAR GLASS AS PER APPROVED VENDOR DETAILS
LOCATION	LIVING ROOM 2.5BHK (DECK)


W1C

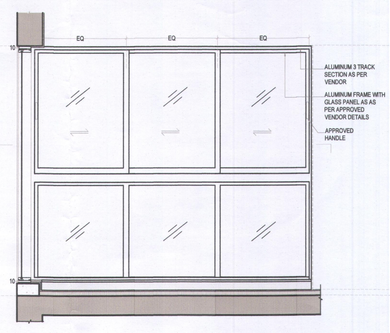

SECTION AA

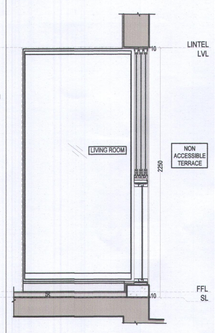


SECTION BB

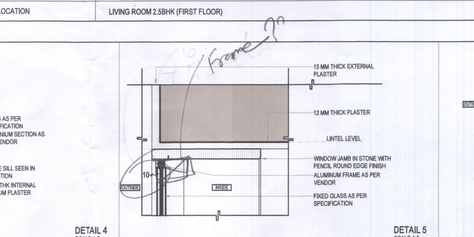

PLAN


TYPE	W1C
STRUCTURAL SIZE OPENING	SLIDING OPENABLE - 2554 X 2140 HT, FIXED GLASS - 1016 X 2140 HT
SILL HEIGHT (FROM SFL)	110
LINTEL HEIGHT (FROM SFL)	2250
DESCRIPTION	POWDER COATED ALUMINUM SLIDING WINDOW WITH CLEAR GLASS AS PER APPROVED VENDOR DETAILS
LOCATION	LIVING ROOM 2.5BHK (FIRST FLOOR)

V1 V1A

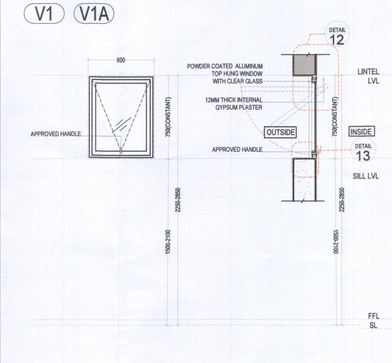

ELEVATION AA
(ELEVATION FROM INSIDE)

SECTION CC

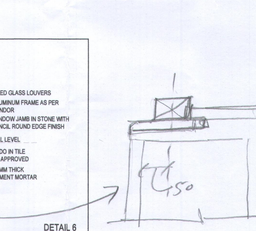

PLAN

TYPE	V1 & V1A-TOP HUNG OPENABLE WINDOW
STRUCTURAL SIZE OPENING	600 X 750(CONSTANT)
SILL HEIGHT (FROM SFL)	1500-2100
LINTEL HEIGHT (FROM SFL)	2250-2850
DESCRIPTION	POWDER COATED ALUMINUM SLIDING WINDOW WITH CLEAR GLASS AS PER APPROVED VENDOR DETAILS
LOCATION	MASTER BEDROOM (2BHK)

GENERAL NOTES

1 : All dimensions are in millimeters and levels in meters unless specified otherwise.
2 : Do not scale the drawing; follow written dimensions.
3 : All dimensions are unfinished dimensions unless specified otherwise.
4 : Any discrepancies should be brought to the notice of the Architect prior to execution of job / procuring materials at site.
5 : This drawing is the property of Kapadia Associates and should not be reproduced, copied, handed over to a third party or used for any purpose other than for which it has been issued.
6 : This drawing is to be read in conjunction with all relevant structural & services drawings.

KEY PLAN

REVISION INDEX

REV.NO.	DATE	DESCRIPTION

CONSULTANTS

STRUCT BOMBAY CONSULTANTS.
Structural Consultants
Tel : 022-24937510,24933986
email : sbcbom@gmail.com

MICRO ENGINEERING
MEP Consultants
Tel : 0120-4558718
email : business@meindia.com

PBB
Planner /Landscape Architect
Tel : 079 6923054
email : landscapeindia@usg.net

STAMP & SIGN

NORTH

N

PROJECT TITLE	PROJ.NO
PALAVA - LAKEFRONT	L-10518
DRAWING TITLE	DWG.NO
WINDOW DETAILS_FLOREA	702.2
DRAWING STAGE	REV.NO
WORKING DRAWING	R-00

DRAWN	CHECKED	SCALE	DATE
VS	ES	1:25	06-11-2019

KAPADIA ASSOCIATES
architecture • urban design
112-114
Peninsula Centre,Dr. S.S. Rao Road,
Off Ambedkar Road,Parel East,
Mumbai 400012
Tel : 91-22-6660 2838 / 39
Fax : 91-22-6660 2844
E-mail : kapl@kapl.in
Website: www.kapl.in