

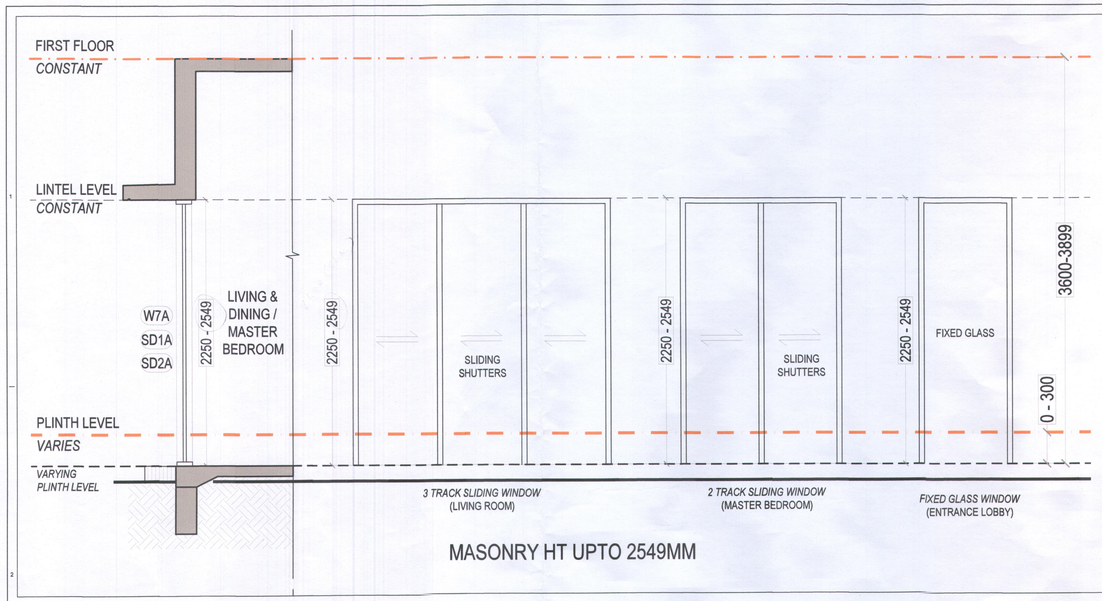


MASONRY HT UPTO 2549MM

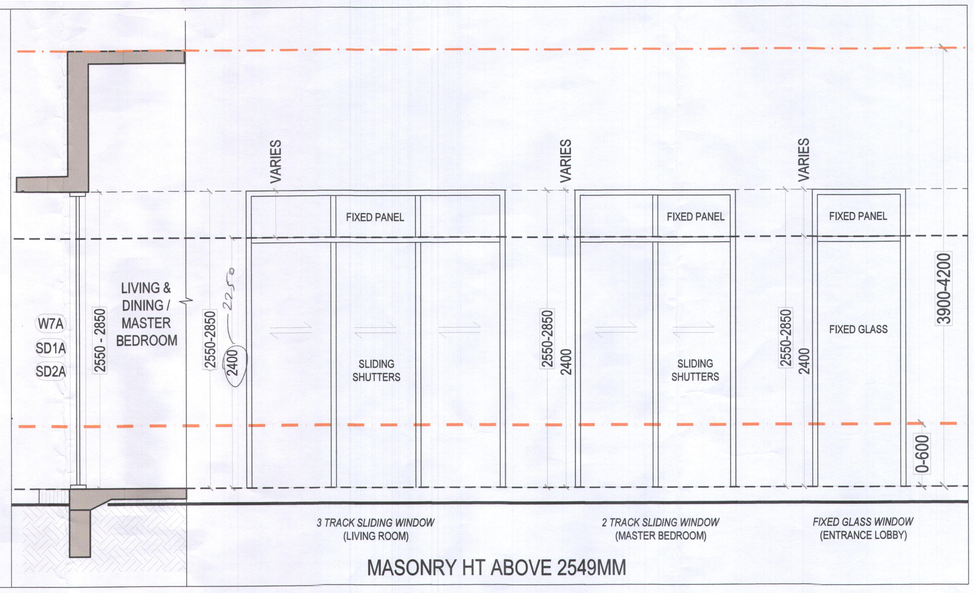


MASONRY HT ABOVE 2549MM

LIVING ROOM & MASTER BEDROOM SLIDING FULL WINDOW AND FIXED GLASS ENT. LOBBY WINDOW

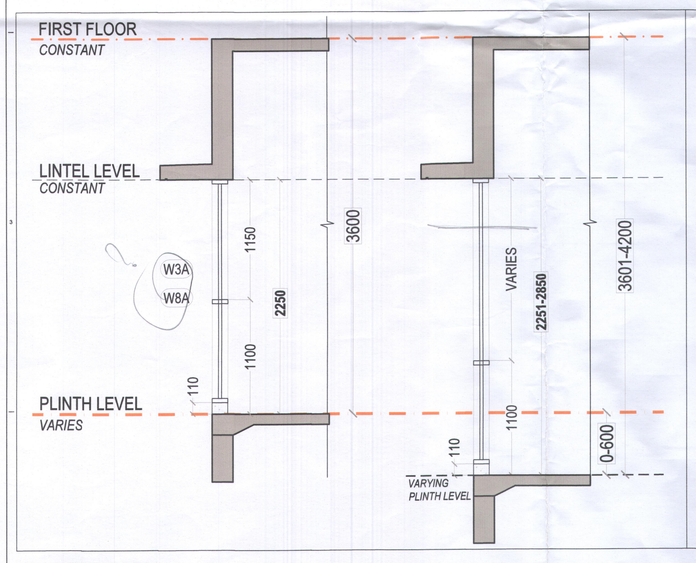


WINDOW

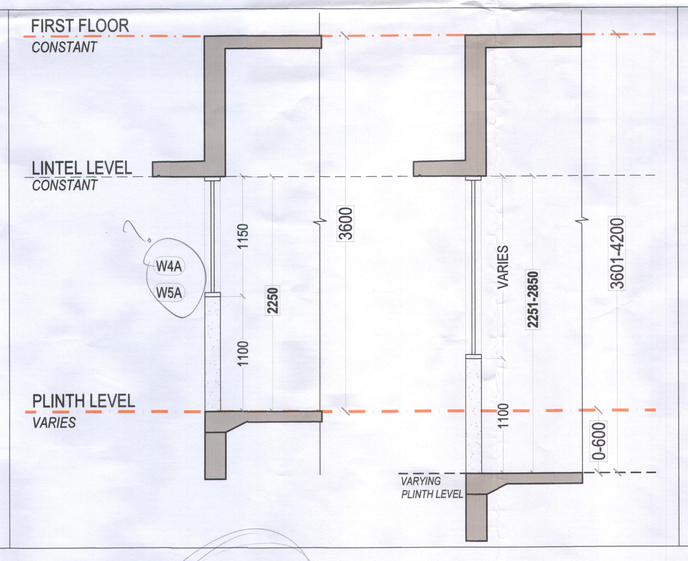

TOILET & STAIRCASE WINDOW

Specific
n/s already
Given in
Arch dwgs.

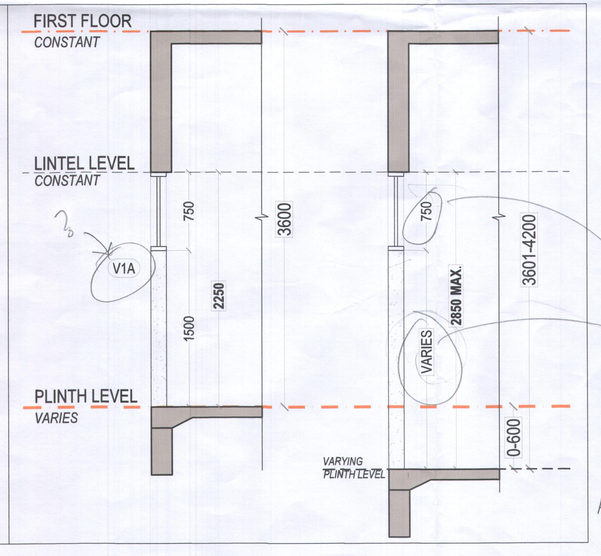

VENTILATOR

Differs from Arch dwgs Already cast @ site as per Schedule Given in plan

GENERAL NOTES

1 : All dimensions are in millimeters and levels in meters unless specified otherwise.
2 : Do not scale the drawing; follow written dimensions.
3 : All dimensions are unfinished dimensions unless specified otherwise.
4 : Any discrepancies should be brought to the notice of the Architect prior to execution of job / procuring materials at site.
5 : This drawing is the property of Kapadia Associates and should not be reproduced, copied, handed over to a third party or used for any purpose other than for which it has been issued.
6 : This drawing is to be read in conjunction with all relevant structural & services drawings.

KEY PLAN

REVISION INDEX

REV.NO.	DATE	DESCRIPTION

CONSULTANTS

STRUCT BOMBAY CONSULTANTS.
Structural Consultants
Tel : 022-24037510,24033986
email : sbcbom@gmail.com

MICRO ENGINEERING
MEP Consultants
Tel : 0120-4558718
email : business@meinda.com

PBB
Planner /Landscape Architect
Tel : 079 6923054
email : landscapeindia@usg.net

STAMP & SIGN	NORTH
	N

PROJECT TITLE	PROJ.NO
PALAVA - LAKEFRONT	L-10518
DRAWING TITLE	DWG.NO
WINDOW DETAIL_FLOREA	702.3
DRAWING STAGE	REV.NO
WORKING DRAWING	R-00

DRAWN	CHECKED	SCALE	DATE
VS	ES	1:25	06-11-2019

KAPADIA ASSOCIATES
architecture • urban design
112-114
Peninsula Centre,Dr. S.S. Rao Road,
Off Ambedkar Road,Parel East,
Mumbai 400012
Tel : 91-22-6660 2838 / 39
Fax : 91-22-6660 2844
E-mail : kapt@kapl.in
Website: www.kapl.in