

W1

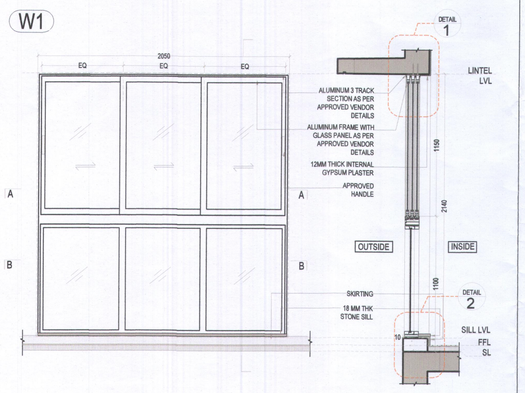


ELEVATION AA
(ELEVATION FROM INSIDE)

SECTION CC

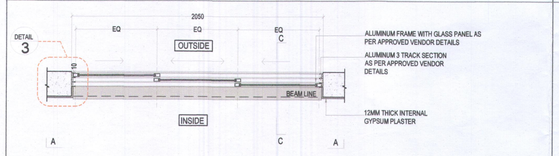


PLAN AT AA

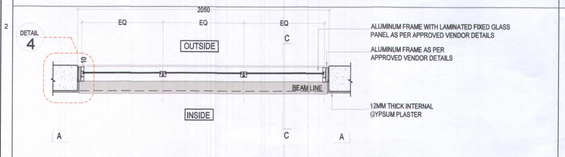

PLAN AT BB

TYPE	W1-THREE SHUTTER SLIDING WINDOW
STRUCTURAL SIZE OPENING	2050 X 2140
SILL HEIGHT (FROM SFL)	110
LINTEL HEIGHT (FROM SFL)	2250
DESCRIPTION	ANODISED ALUMINIUM SLIDING WINDOW WITH CLEAR GLASS OF APPROVED MAKE & COLOUR PROVIDED WITH LOCKING SYSTEM & HANDLES
LOCATION	LIVING ROOM (SECOND FLOOR)


W2 W2A W3 W3A

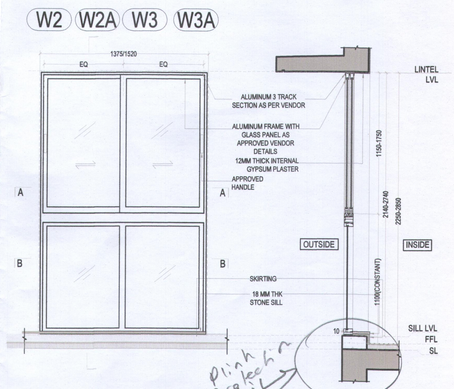


ELEVATION AA
(ELEVATION FROM INSIDE)

plinth protection detail

SECTION CC

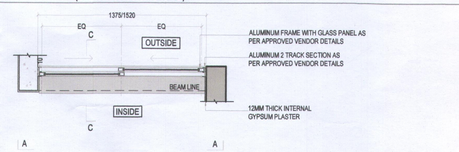


PLAN AT AA

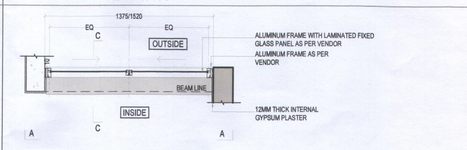

PLAN AT BB


TYPE	W2, W3 & W3A -TWO SHUTTER SLIDING WINDOW WITH FIXED PANEL(LOWER)
STRUCTURAL SIZE OPENING	1365/1520 X 2140-2740
SILL HEIGHT (FROM SFL)	110
LINTEL HEIGHT (FROM SFL)	2250-2850
DESCRIPTION	ANODISED ALUMINIUM SLIDING WINDOW WITH CLEAR GLASS OF APPROVED MAKE & COLOUR PROVIDED WITH LOCKING SYSTEM & HANDLES
LOCATION	MASTER BEDROOM & BEDROOM - 02

W3B

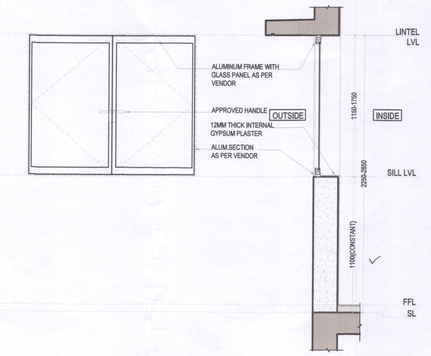

ELEVATION AA
(ELEVATION FROM INSIDE)


SECTION CC

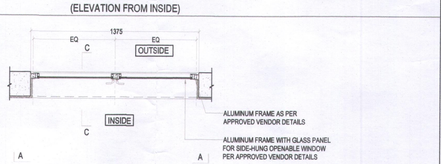

PLAN AT AA


TYPE	W3B -TWO SHUTTER SLIDING WINDOW
STRUCTURAL SIZE OPENING	1375 X 1150-1750
SILL HEIGHT (FROM SFL)	1100(CONSTANT) ✓
LINTEL HEIGHT (FROM SFL)	2250-2850
DESCRIPTION	ANODISED ALUMINIUM SLIDING WINDOW WITH CLEAR GLASS OF APPROVED MAKE & COLOUR PROVIDED WITH LOCKING SYSTEM & HANDLES
LOCATION	GROUND FLOOR KITCHEN

W4 W4A

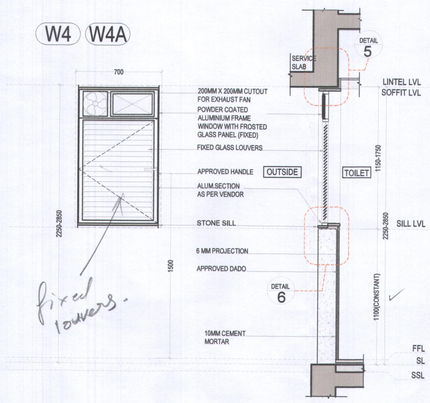

ELEVATION AA
(ELEVATION FROM TOILET)

SECTION CC

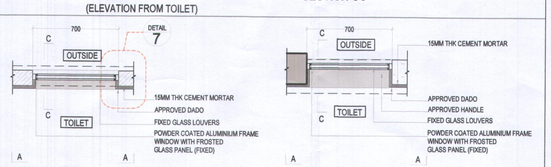


PLAN (TOILET-02)

PLAN (M.TOILET)

TYPE	W4 & W4A - LOUVERED WINDOW WITH EXHAUST
STRUCTURAL SIZE OPENING	700 X 1150-1750
SILL HEIGHT (FROM SFL)	1100(CONSTANT) ✓
LINTEL HEIGHT (FROM SFL)	2250-2850
DESCRIPTION	ANODISED ALUMINIUM FRAME PARTLY FIXED AND PARTLY LOUVERED WINDOW WITH EXHAUST FAN & ANODISED ALUMINIUM LOUVERS OF APPROVED MAKE & COLOUR PROVIDED WITH LOCKING SYSTEM & HANDLES
LOCATION	TOILET


W5 W5C

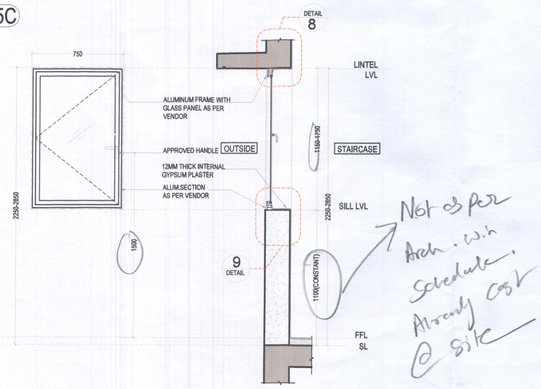


Not as per Arch. win schedule. Already cast @ site

ELEVATION AA
(ELEVATION FROM INSIDE)

SECTION CC

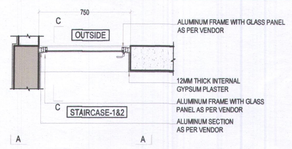


PLAN (W5)

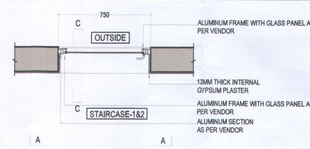

PLAN(W5C)
(GROUND FLOOR)

TYPE	W5 & W5C - SIDE HUNG OPENABLE WINDOW
STRUCTURAL SIZE OPENING	750 X 1150-1750
SILL HEIGHT (FROM SFL)	1100(CONSTANT)
LINTEL HEIGHT (FROM SFL)	2250-2850
DESCRIPTION	ANODISED ALUMINIUM SIDE HUNG OPENABLE WINDOW WITH CLEAR GLASS OF APPROVED MAKE & COLOUR PROVIDED WITH LOCKING SYSTEM, FRICTION HINGE & HANDLES
LOCATION	STAIRCASE

SD1 SD1A

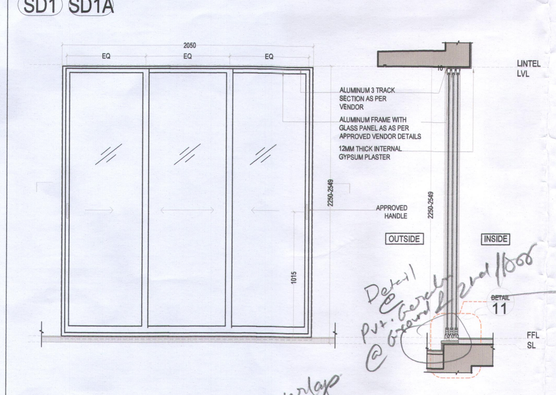



ELEVATION AA
(ELEVATION FROM INSIDE)

overlap


SECTION CC

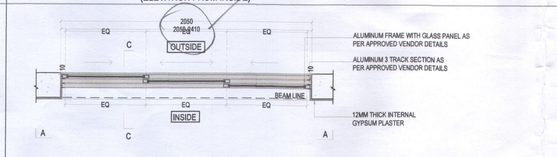

PLAN


TYPE	SD1 & SD1A -THREE SHUTTER SLIDING WINDOW
STRUCTURAL SIZE OPENING	2050 X 2250-2549
SILL HEIGHT (FROM SFL)	0
LINTEL HEIGHT (FROM SFL)	2250-2549
DESCRIPTION	ANODISED ALUMINIUM SLIDING WINDOW WITH CLEAR GLASS OF APPROVED MAKE & COLOUR PROVIDED WITH LOCKING SYSTEM & HANDLES
LOCATION	LIVING ROOM (DECK & GARDEN APT.)

SD2 SD2A

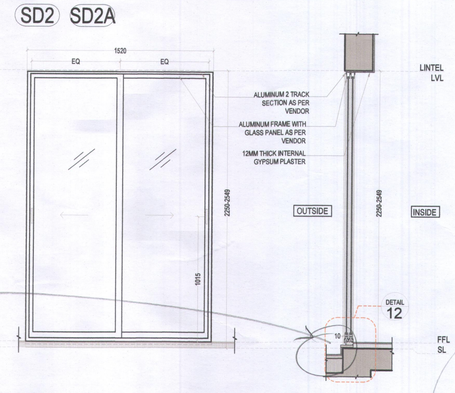

ELEVATION AA
(ELEVATION FROM INSIDE)


SECTION CC

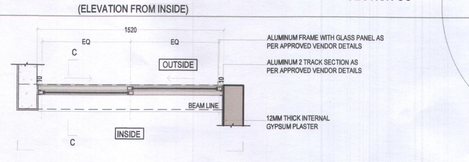

PLAN


TYPE	SD2 & SD2A -TWO SHUTTER SLIDING WINDOW
STRUCTURAL SIZE OPENING	1520 X 2250-2549
SILL HEIGHT (FROM SFL)	0
LINTEL HEIGHT (FROM SFL)	2250-2549
DESCRIPTION	ANODISED ALUMINIUM SLIDING WINDOW WITH CLEAR GLASS OF APPROVED MAKE & COLOUR PROVIDED WITH LOCKING SYSTEM & HANDLES
LOCATION	MASTER BEDROOM (GARDEN APT.)

W6 W6A

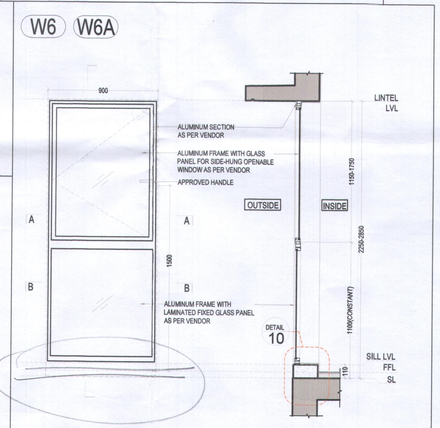


ELEVATION AA
(ELEVATION FROM INSIDE)

SECTION CC

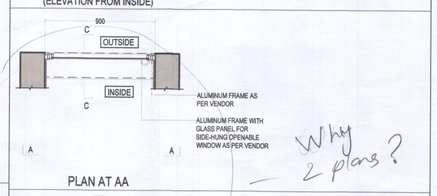

PLAN AT AA

Why 2 plans?

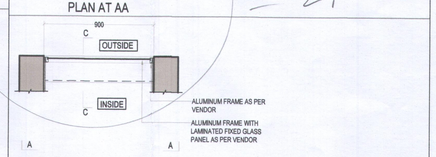

PLAN AT BB

TYPE	W6 & W6A - SIDE HUNG OPENABLE WINDOW
STRUCTURAL SIZE OPENING	900 X 2140-2740
SILL HEIGHT (FROM SFL)	110
LINTEL HEIGHT (FROM SFL)	2250-2850
DESCRIPTION	ANODISED ALUMINIUM SLIDING WINDOW WITH CLEAR GLASS OF APPROVED MAKE & COLOUR PROVIDED WITH LOCKING SYSTEM & HANDLES
LOCATION	FLOOR LOBBY

GENERAL NOTES

1 : All dimensions are in millimeters and levels in meters unless specified otherwise.
2 : Do not scale the drawing; follow written dimensions.
3 : All dimensions are unfinished dimensions unless specified otherwise.
4 : Any discrepancies should be brought to the notice of the Architect prior to execution of job / procuring materials at site.
5 : This drawing is the property of Kapadia Associates and should not be reproduced, copied, handed over to a third party or used for any purpose other than for which it has been issued.
6 : This drawing is to be read in conjunction with all relevant structural & services drawings.

KEY PLAN

DS @ 2nd floor missing

REVISION INDEX

REV.NO.	DATE	DESCRIPTION

CONSULTANTS

STRUCT BOMBAY CONSULTANTS.
Structural Consultants
Tel : 022-24937510,24933986
email : sbcbom@gmail.com

MICRO ENGINEERING
MEP Consultants
Tel : 0120-4558718
email : business@meindia.com

PBB
Planner /Landscape Architect
Tel : 079 6923054
email : landscapeindia@usg.net

STAMP & SIGN	NORTH
	N
PROJECT TITLE	PROJ.NO
PALAVA - LAKEFRONT	L-10518
DRAWING TITLE	DWG.NO
WINDOW DETAILS_OLIVIA	702.4
DRAWING STAGE	REV.NO
WORKING DRAWING	R-00

DRAWN	CHECKED	SCALE	DATE
VS	ES	1:25	06-11-2019

KAPADIA ASSOCIATES
architecture • urban design
112-114, Peninsula Centre,Dr. S.S. Rao Road, Off Ambedkar Road,Parel East, Mumbai 400012
Tel : 91-22-6660 2838 / 39
Fax : 91-22-6660 2844
E-mail : kapl@kapl.in
Website: www.kapl.in